


H
G
F
E
D
C
B
A

8 7 6 5 4 3 2 1

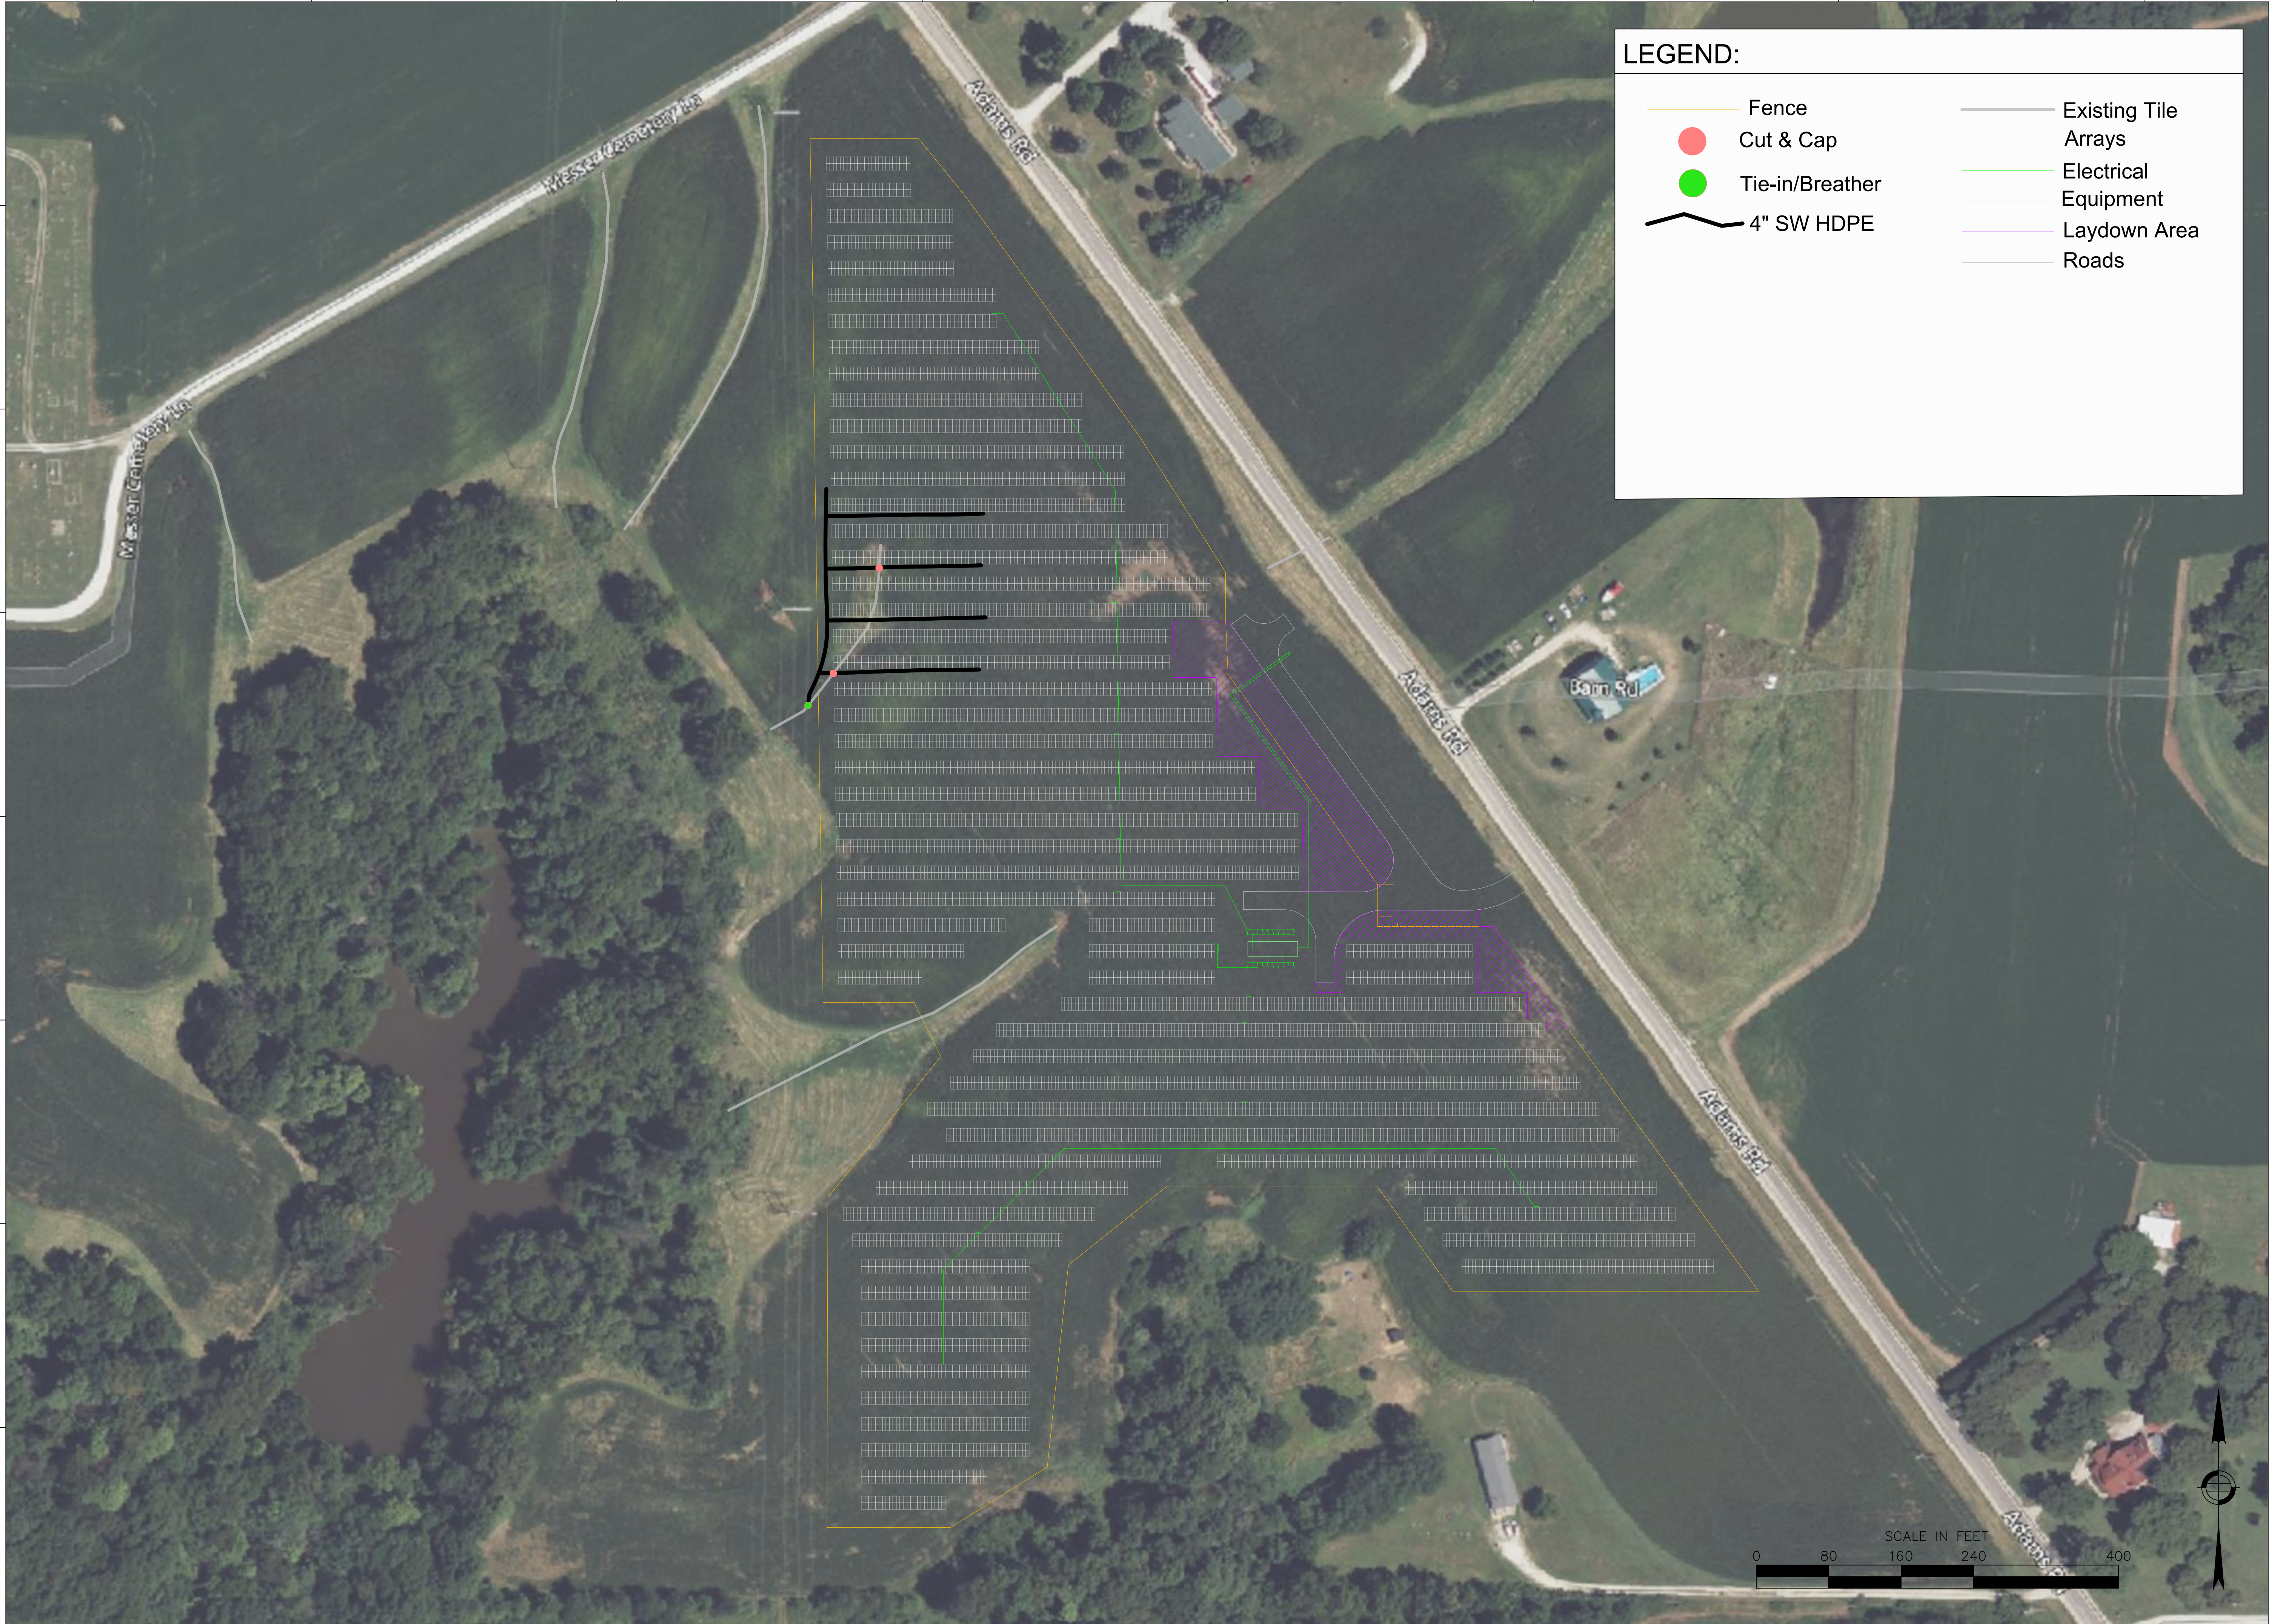

LEGEND:

- Fence
- Cut & Cap
- Tie-in/Breather
- 4" SW HDPE
- Existing Tile Arrays
- Electrical Equipment
- Laydown Area
- Roads

nexamp
101 Summer Street, Boston, MA 02110
Tel: (617) 431-1440 Fax: (978) 416-2525 Web: nexamp.com



Rev	Issued For	Date	Init
0	AS-BUILT	09/23/2025	JD

Project: **138883 Cemetery Sun LLC**

Drawing Title: **AS-BUILT**
Scale: 1"=80'
Drawn by: J Dinger

Dwg No: **DT-101**
Size: D
Sheet Rev: **0**