


H  
G  
F  
E  
D  
C  
B  
A

8  
7  
6  
5  
4  
3  
2  
1

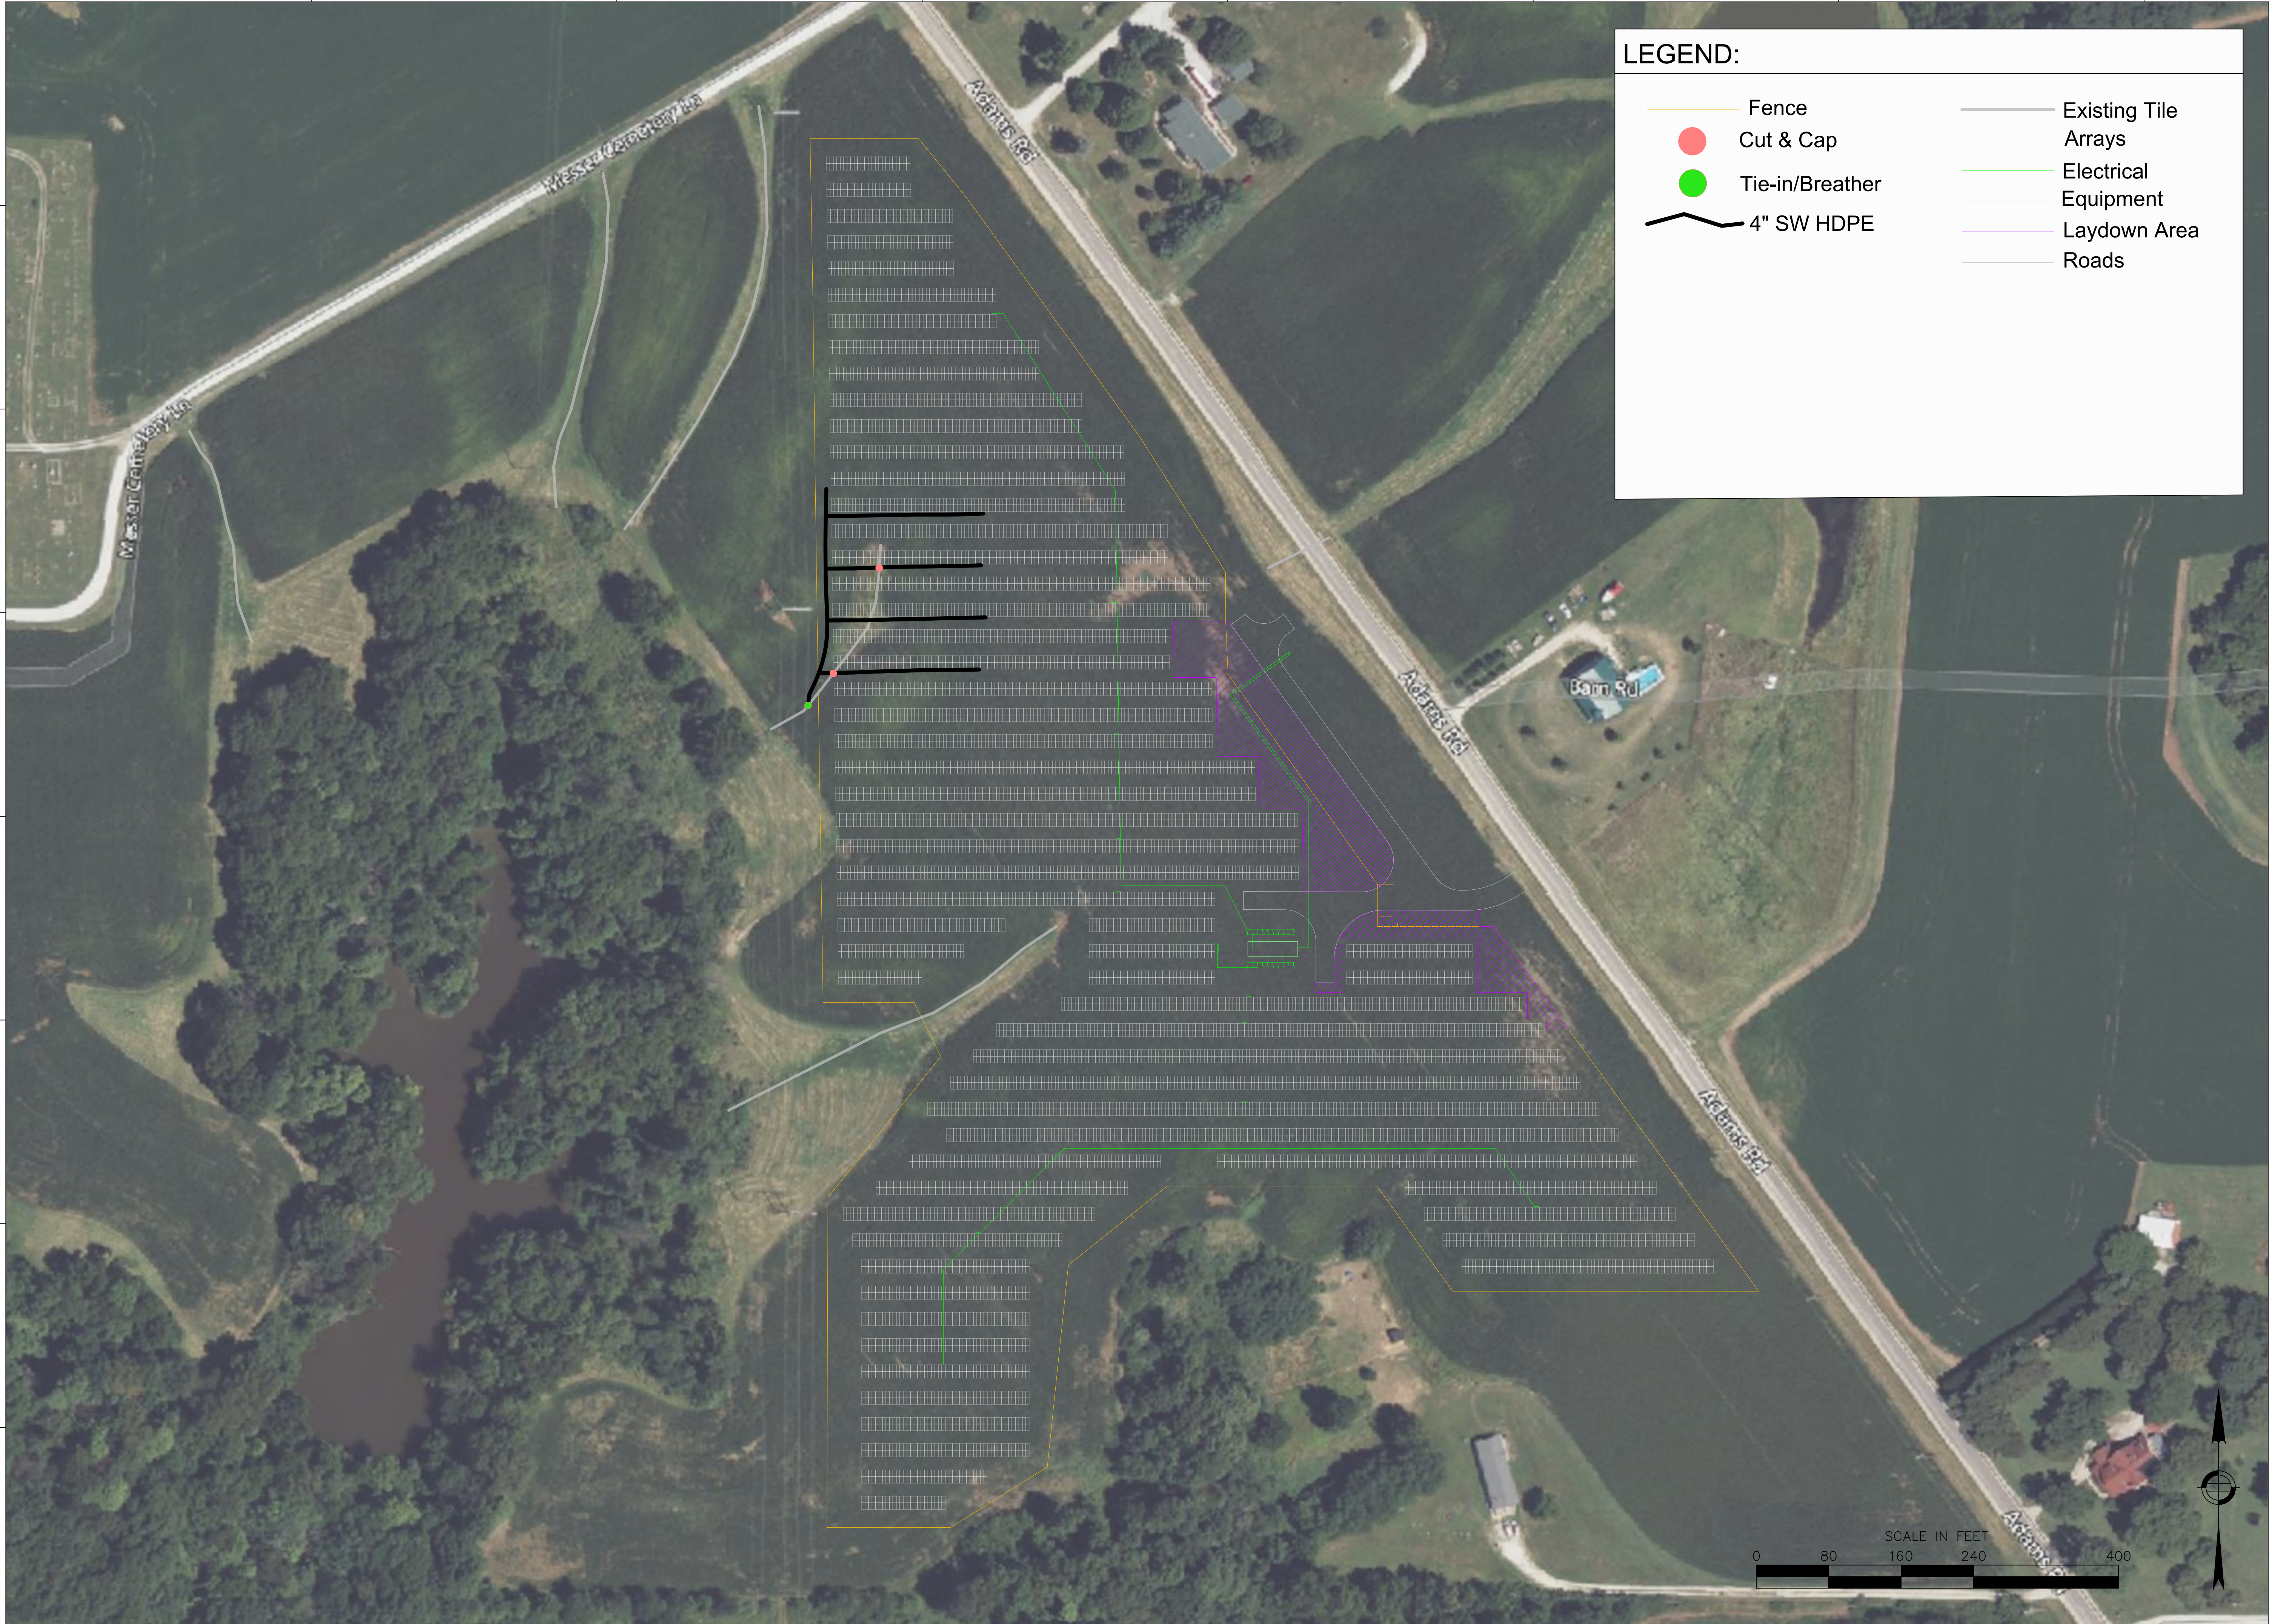

**LEGEND:**

- Fence
- Cut & Cap
- Tie-in/Breather
- 4" SW HDPE
- Existing Tile Arrays
- Electrical Equipment
- Laydown Area
- Roads

**nexamp**  
101 Summer Street, Boston, MA 02110  
Tel: (617) 431-1440 Fax: (978) 416-2525 Web: nexamp.com



Rev	Issued For	Date	Init
0	AS-BUILT	09/23/2025	JD

Project: **138883 Cemetery Sun LLC**

Drawing Title: **AS-BUILT**  
Scale: 1"=80'  
Drawn by: J Dinger

Dwg No: **DT-101**  
Size: D  
Sheet Rev: **0**